INDEX OF SHEETS

- COVER SHEET
- **GENERAL NOTES & STANDARDS**
- SUMMARY OF QUANTITIES
- TYPICAL SECTIONS
- SCHEDULE OF QUANTITIES 5-7
- TIE POINTS
- 9 13 PROJECT LAYOUT
- PAVEMENT MARKING PLAN
- 20 22

HIGHWAY STANDARDS

STANDARD SYMBOLS, ABBREVIATIONS AND PATTERNS CLASS C AND D PATCHES

MAILBOX TURNOUT 406201**-01**

000001-05 442201-03

701001-*0*i

701011-01

701306-01

MICROFILMED

RESIDENT ENGINEER

1-800-892-0123

AS BUILT CHANGES WERE MADE

DISTRICT 3 NO. (815) 434-6131

UNIT CHIEF: BRAD DUNCAN

TOWNSHIP: SULLIVANT, DRUMMER

PROJECT ENGINEER: DAVE BROVIAK

ON THE FOLLOWING SHEETS _

REFLECTOR MARKER AND MOUNTING DETAILS 635011-01

667101 PERMANENT SURVEY MARKERS

OFF-RD OPERATION 2L, 2W, 15' MIN. AWAY FOR SPEEDS **EQUAL OR GREATER THAN 45 MPH**

OFF-ROAD OPERATIONS 2L, 2W 15' TO PAVEMENT EDGE FOR 701006-02

SPEEDS EQUAL OR GREATER THAN 45 MPH

OFF-ROAD MOVING OPERATIONS 2L, 2W DAY ONLY FOR SPEEDS **EQUAL OR GREATER THAN 45 MPH**

701301-02 LANE CLOSURE 2L, 2W SHORT TIME OPERATIONS

LANE CLOSURE 2L, 2W SLOW MOVING OPERATIONS - DAY ONLY

FOR SPEEDS EQUAL OR GREATER THAN 45 MPH

701311-02 LANE CLOSURE 2L, 2W MOVING OPERATIONS - DAY ONLY

LANE CLOSURE 2L, 2W WORK AREAS IN SERIES FOR SPEEDS 701336-04

EQUAL TO OR GREATER THAN 45MPH

TRAFFIC CONTROL DEVICES 701901

LANE CLOSURE, 2L. 2W. DAY ONLY, FOR SPEEDS 245 MPH 701201-02

JOINT UTILITY LOCATION INFORMATION FOR EXCAVATION

TYPICAL APPLICATIONS, RAISED REFLECTIVE PAVEMENT MARKERS 781001-02

STRUCTURE NO. 027-2007 STA. 343 + 11

EXPIRES

STATE OF ILLINOIS

DEPARTMENT OF TRANSPORTATION

DIVISION OF HIGHWAYS

PLANS FOR PROPOSED FEDERAL AID HIGHWAY

F.A.P. ROUTE 326 (IL 47)

SECTION (125)RS-5, (126)RS-3 & (127X)RS-2


PROJECT F-0326 (071)

FORD COUNTY

C-93-025-04

3P RESURFACING & MILLING IL. 47

FROM RTE. 9 TO LIVINGSTON CO. LINE

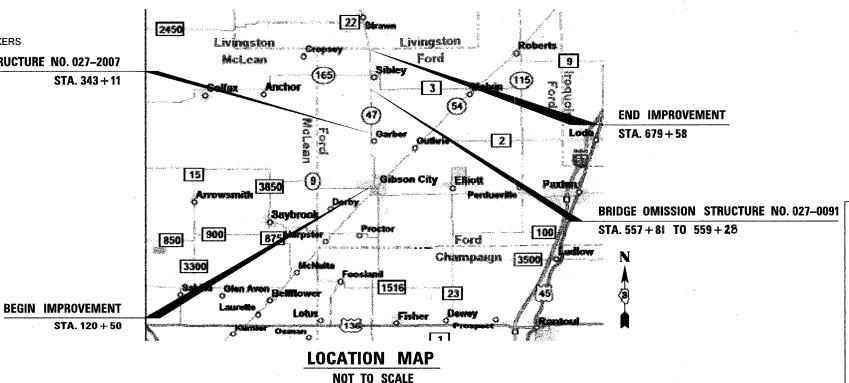


GROSS LENGTH = 55,908 FT. = 10.59 MI. NET LENGTH = 55,761 FT. = 10.56 MI.

CONTRACT # 66423

F.A.P. RTE SECTION COUNTY TOTAL SHEET NO. 326 * FORD 22 1 ILLINOIS PROJECT D-93-033-03 (125)RS-5, (126)RS-3 & (127X)RS-2

D-93-024-04

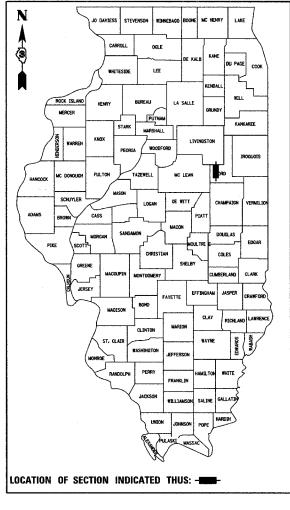

FUNCTION CLASSIFICATION RURAL OTHER PRINCIPAL ARTERIAL

2006 ADT = 3450

P.V. = 70.3% S.U. = 9.4% M.U. = 20.3%

STATE OF ILLINOIS
DEPARTMENT OF TRANSPORTATION **DIVISION OF HIGHWAYS**

Y MRECTOR OF HIGHWAYS, REGION ENGINEER ____ 20<u>08</u> E-Harn D M. Red B DIRECTOR OF HIGHWAYS, CHIEF ENGINEER

> PRINTED BY THE AUTHORITY OF THE STATE OF ILLINOIS

CONTRACT NO. 66423